




40-PFD-9002.dwg Plotted on: Oct 28, 2020 by andeken1

D

C

B

A

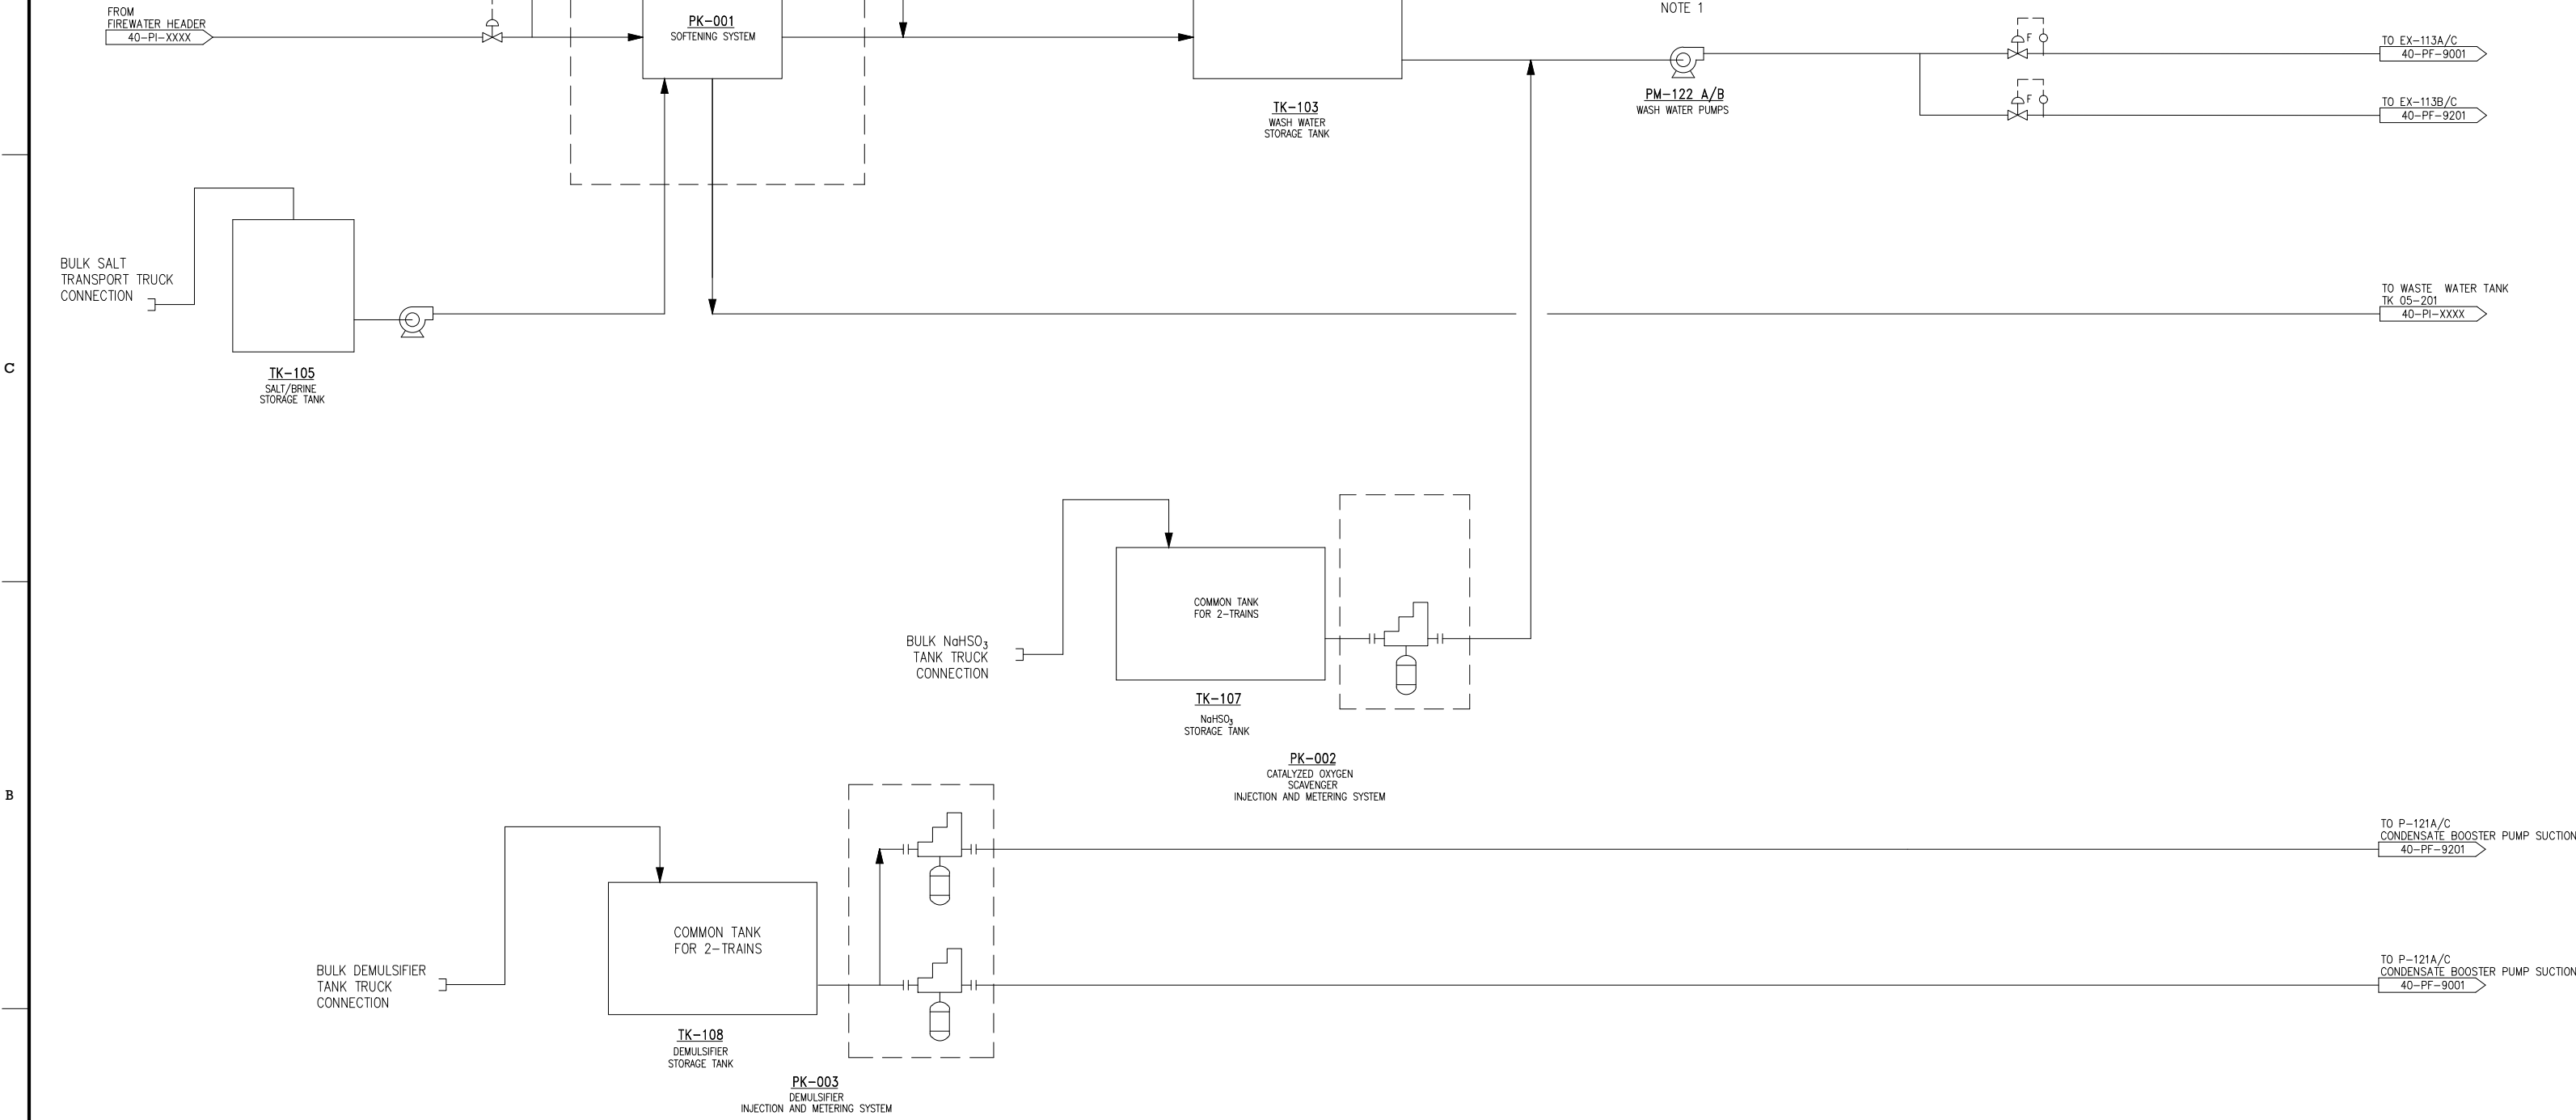

- NOTES:
- 2 PUMPS - ONE A COMMON SPARE.
 - SHARED EQUIPMENT WITH 2-TRAINS IS SHOWN IN RED.

1				06/28/19	CDL	TWA	AS BUILT PER DESALTER		KINDER MORGAN CRUDE & CONDENSATE LLC		PROCESS FLOW DIAGRAM GALENA PARK SPLITTER DESALTER WASH WATER TREATING GALENA PARK TX		REVISION 40-PFD-9002 1					
0				04/12/18	BTf	SJM	DESALTER ISSUED FOR CONSTRUCTION											
D				03/21/18	CDL	SJM	PER MOC-KM-008											
NO.	DATE	DRAWN	CHECKED	DESCRIPTION				APP.	DATE	SCALE	CHECKED							
REVISIONS														DRAWN:	PLOT SCALE:	APPROVED:		

AECOM URS JOB NO. 34415-100
TX REG.: F-2660 38988286-PFD-9002-D

